

THIS DRAWING IS UNPUBLISHED. RELEASED FOR PUBLICATION -,- -
© COPYRIGHT 2005 BY TYCO ELECTRONICS CORPORATION. ALL RIGHTS RESERVED.


LOC	DIST
AD	00

REVISIONS


P	LTR	DESCRIPTION	DATE	DWN	APVD
	U	REVISED PER ECN 0S12-0287-05	15MAY06	JDP	AMS
	U1	REVISED PER ECO-09-021826	09JAN10	KK	AEG

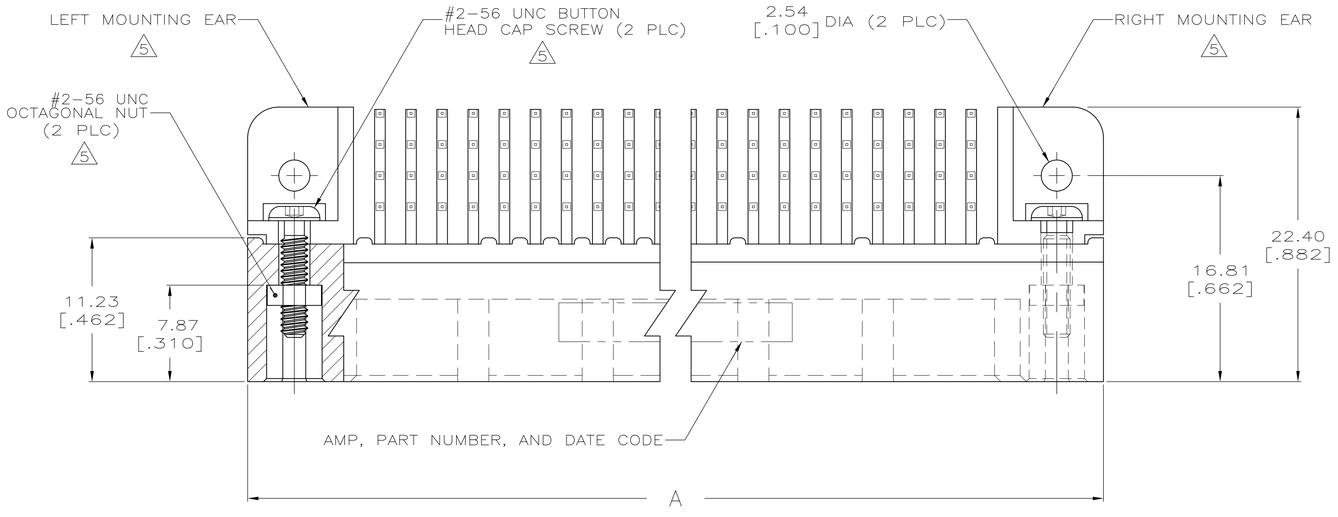

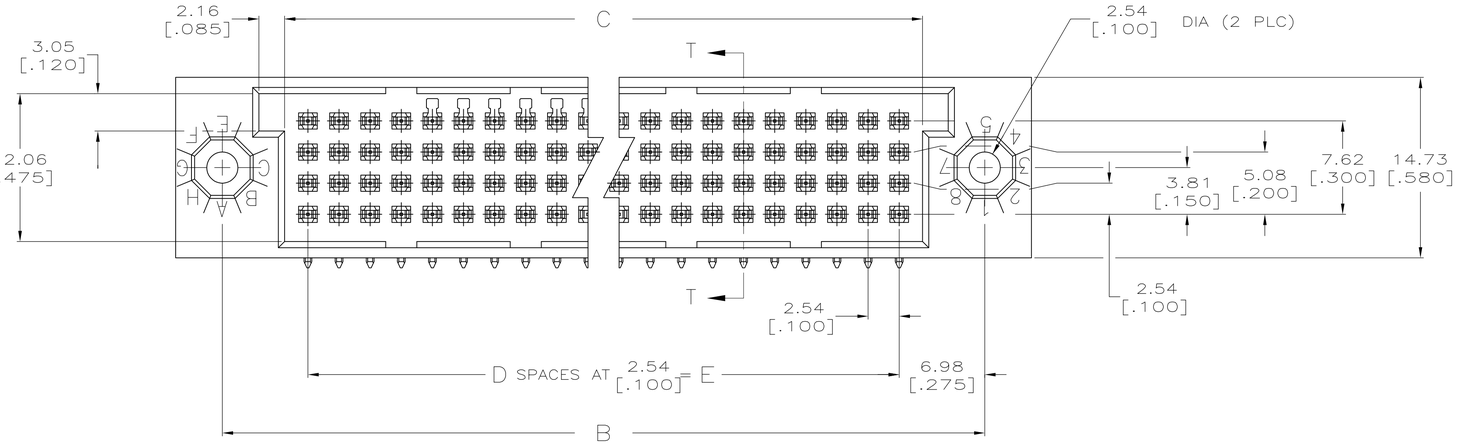

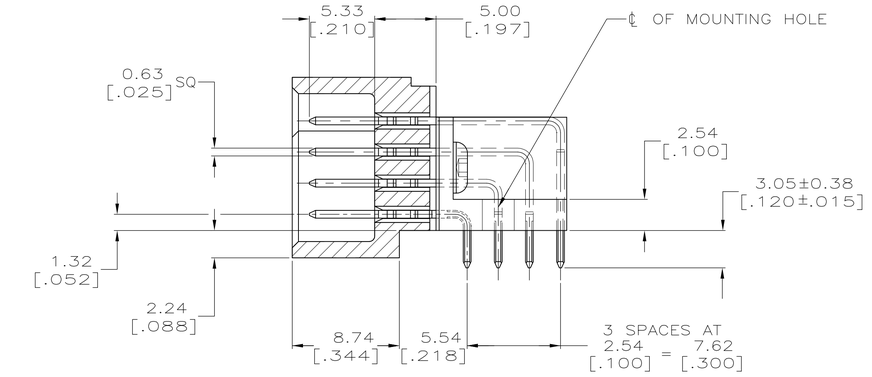

SECTION T-T

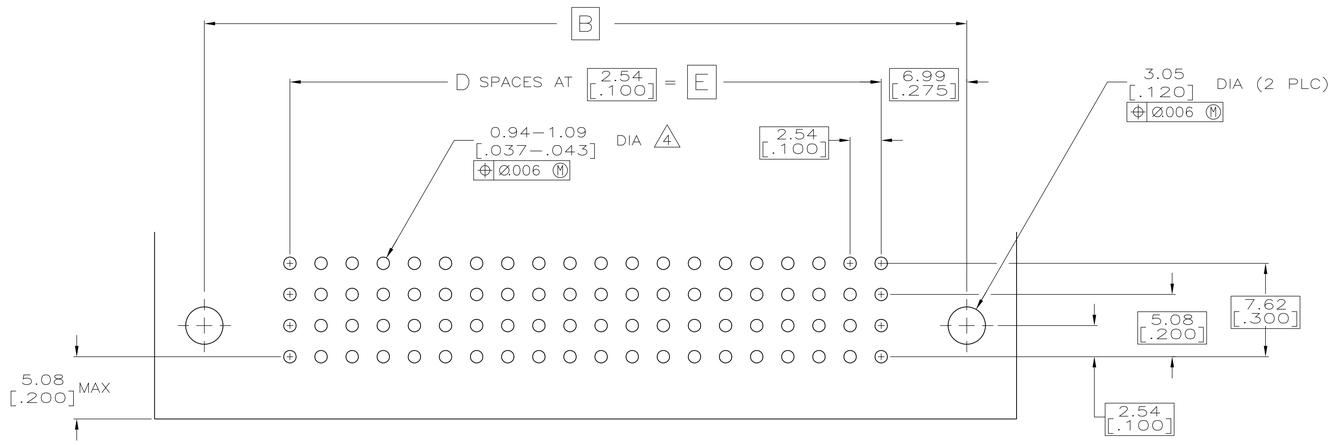

RECOMMENDED P.C. BOARD LAYOUT

THIS DRAWING IS A CONTROLLED DOCUMENT.

DIMENSIONS: mm [INCHES]

TOLERANCES UNLESS OTHERWISE SPECIFIED:
0 PLC ± –
1 PLC ± –
2 PLC ± –
3 PLC ± 0.13 [.005]
4 PLC ± –
ANGLES ± –

MATERIAL 1 2
FINISH 3

DWN	R.K. SEIFRIED 05/14/90
CHK	G.SKIPPER 01/22/92
APVD	G.SKIPPER 01/22/92
PRODUCT SPEC	—
APPLICATION SPEC	—
WEIGHT	—

Tyco Electronics
Tyco Electronics Corporation
Harrisburg, PA 17105-3608

NAME
ASSY,HDI,4 ROW,RIGHT ANGLE PIN
3.05 [.120] LONG SOLDER TAILS,
.00076 [.000030] GOLD PLATE

SIZE	CAGE CODE	DRAWING NO	RESTRICTED TO
A1	00779	C-533286	—

CUSTOMER DRAWING | SCALE 4:1 | SHEET 1 OF 2 | REV U1

THIS DRAWING IS UNPUBLISHED. RELEASED FOR PUBLICATION -,- .
© COPYRIGHT 2005 BY TYCO ELECTRONICS CORPORATION. ALL RIGHTS RESERVED.

LOC	DIST
AD	00

REVISIONS

P	LTR	DESCRIPTION	DATE	DWN	APVD
	—	SEE SHEET 1	–	—	—

1. HOUSING MATERIAL: THERMOPLASTIC, COLOR—BLACK.
2. CONTACT MATERIAL: PHOSPHOR BRONZE.
3. CONTACT FINISH: .00127—.00254 [.000050—.000100] NICKEL UNDERPLATE ALL OVER; .00076 [.000030] GOLD PLATE IN CONTACT AREA, TIN—LEAD PLATED SOLDER TAILS.
4. RIGHT ANGLE PIN RECOMMENDED P.C. BOARD HOLE SIZES ARE 0.94—1.09 [.037—.043]; RECOMMENDED PAD DIA IS 1.52 [.060].
5. MOUNTING EARS AND HARDWARE PURCHASED SEPARATELY, KIT PART NUMBER 533050—1.
6. DIMENSIONS IN BRACKETS ARE IN INCHES.
7. HOUSINGS WITH CENTER MOUNTING IS RECOMMENDED FOR ASSEMBLIES HAVING 75 CONTACTS PER ROW OR MORE.
8. PART NUMBER IS OBSOLETE.
9. OBSOLETE PARTS: OBSOLETE CIS STREAMLINING PER D.RENAUD/D.SINISI

E	D	C	B	A	POSN	PART NUMBER
144.78 [5.700]	~~57~~	148.59 [5.850]	158.75 [6.250]	166.37 [6.550]	~~232~~	3—533286—5
134.62 [5.300]	~~53~~	138.43 [5.450]	148.59 [5.850]	156.21 [6.150]	~~216~~	3—533286—4
–	–	–	–	–	–	3—533286—3
–	–	–	–	–	–	3—533286—2
–	–	–	–	–	–	3—533286—1
–	–	–	–	–	–	3—533286—0
–	–	–	–	–	–	2—533286—9
–	–	–	–	–	–	2—533286—8
–	–	–	–	–	–	2—533286—7
–	–	–	–	–	–	2—533286—6
–	–	–	–	–	–	2—533286—5
–	–	–	–	–	–	2—533286—4
–	–	–	–	–	–	2—533286—3
–	–	–	–	–	–	2—533286—2
–	–	–	–	–	–	2—533286—1
–	–	–	–	–	–	2—533286—0
–	–	–	–	–	–	1—533286—9
–	–	–	–	–	–	1—533286—8
–	–	–	–	–	–	~~1—533286—7~~
–	–	–	–	–	–	1—533286—6
93.98 [3.700]	~~37~~	97.79 [3.850]	107.95 [4.250]	115.57 [4.550]	~~152~~	1—533286—5
210.82 [8.300]	~~83~~	214.63 [8.450]	224.79 [8.850]	232.41 [9.150]	~~336~~	1—533286—4
200.66 [7.900]	~~79~~	204.47 [8.050]	214.63 [8.450]	222.25 [8.750]	~~320~~	1—533286—3
187.96 [7.400]	74	191.77 [7.550]	201.93 [7.950]	209.55 [8.250]	300	~~1—533286—2~~
175.26 [6.900]	~~69~~	179.07 [7.050]	189.23 [7.450]	196.85 [7.750]	~~280~~	1—533286—1
162.56 [6.400]	~~64~~	166.37 [6.550]	176.53 [6.950]	184.15 [7.250]	~~260~~	1—533286—0
149.86 [5.900]	59	153.67 [6.050]	163.83 [6.450]	171.45 [6.750]	240	533286—9
137.16 [5.400]	~~54~~	140.97 [5.550]	151.13 [5.950]	158.75 [6.250]	~~220~~	533286—8
124.46 [4.900]	~~49~~	128.27 [5.050]	138.43 [5.450]	146.05 [5.750]	~~200~~	533286—7
111.76 [4.400]	44	115.57 [4.550]	125.73 [4.950]	133.35 [5.250]	180	533286—6
99.06 [3.900]	39	102.87 [4.050]	113.03 [4.450]	120.65 [4.750]	160	533286—5
86.36 [3.400]	~~34~~	90.17 [3.550]	100.33 [3.950]	107.95 [4.250]	~~140~~	533286—4
78.74 [3.100]	31	82.55 [3.250]	92.71 [3.650]	100.33 [3.950]	128	533286—3
73.66 [2.900]	29	77.47 [3.050]	87.63 [3.450]	95.25 [3.750]	120	533286—2
60.96 [2.400]	24	64.77 [2.550]	74.93 [2.950]	82.55 [3.250]	100	533286—1

OBSOLETE

THIS DRAWING IS A CONTROLLED DOCUMENT.

DIMENSIONS: mm [INCHES]

TOLERANCES UNLESS OTHERWISE SPECIFIED:
0 PLC ± –
1 PLC ± –
2 PLC ± –
3 PLC ± 0.13 [.005]
4 PLC ± –
ANGLES ± –

MATERIAL 1 2

FINISH 3

DWN R.K. SEIFRIED 05/14/90
CHK G.SKIPPER 01/22/92
APVD G.SKIPPER 01/22/92
PRODUCT SPEC —
APPLICATION SPEC —
WEIGHT –

Tyco Electronics
Tyco Electronics Corporation
Harrisburg, PA 17105—3608

NAME
ASSY,HDI,4 ROW,RIGHT ANGLE PIN
3.05 [.120] LONG SOLDER TAILS,
.00076 [.000030] GOLD PLATE

SIZE	CAGE CODE	DRAWING NO	RESTRICTED TO
A1	00779	C-533286	—

CUSTOMER DRAWING

SCALE 4:1 SHEET 2 OF 2 REV U1


Компания «ЭлектроПласт» предлагает заключение долгосрочных отношений при поставках импортных электронных компонентов на взаимовыгодных условиях!

Наши преимущества:

- Оперативные поставки широкого спектра электронных компонентов отечественного и импортного производства напрямую от производителей и с крупнейших мировых складов;
- Поставка более 17-ти миллионов наименований электронных компонентов;
- Поставка сложных, дефицитных, либо снятых с производства позиций;
- Оперативные сроки поставки под заказ (от 5 рабочих дней);
- Экспресс доставка в любую точку России;
- Техническая поддержка проекта, помощь в подборе аналогов, поставка прототипов;
- Система менеджмента качества сертифицирована по Международному стандарту ISO 9001;
- Лицензия ФСБ на осуществление работ с использованием сведений, составляющих государственную тайну;
- Поставка специализированных компонентов (Xilinx, Altera, Analog Devices, Intersil, Interpoint, Microsemi, Aeroflex, Peregrine, Syfer, Eurofarad, Texas Instrument, Miteq, Cobham, E2V, MA-COM, Hittite, Mini-Circuits,General Dynamics и др.);

Помимо этого, одним из направлений компании «ЭлектроПласт» является направление «Источники питания». Мы предлагаем Вам помощь Конструкторского отдела:

- Подбор оптимального решения, техническое обоснование при выборе компонента;
- Подбор аналогов;
- Консультации по применению компонента;
- Поставка образцов и прототипов;
- Техническая поддержка проекта;
- Защита от снятия компонента с производства.

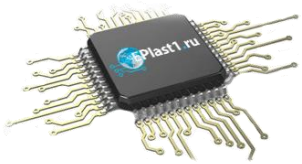

Как с нами связаться

Телефон: 8 (812) 309 58 32 (многоканальный)
Факс: 8 (812) 320-02-42
Электронная почта: org@eplast1.ru
Адрес: 198099, г. Санкт-Петербург, ул. Калинина, дом 2, корпус 4, литера А.